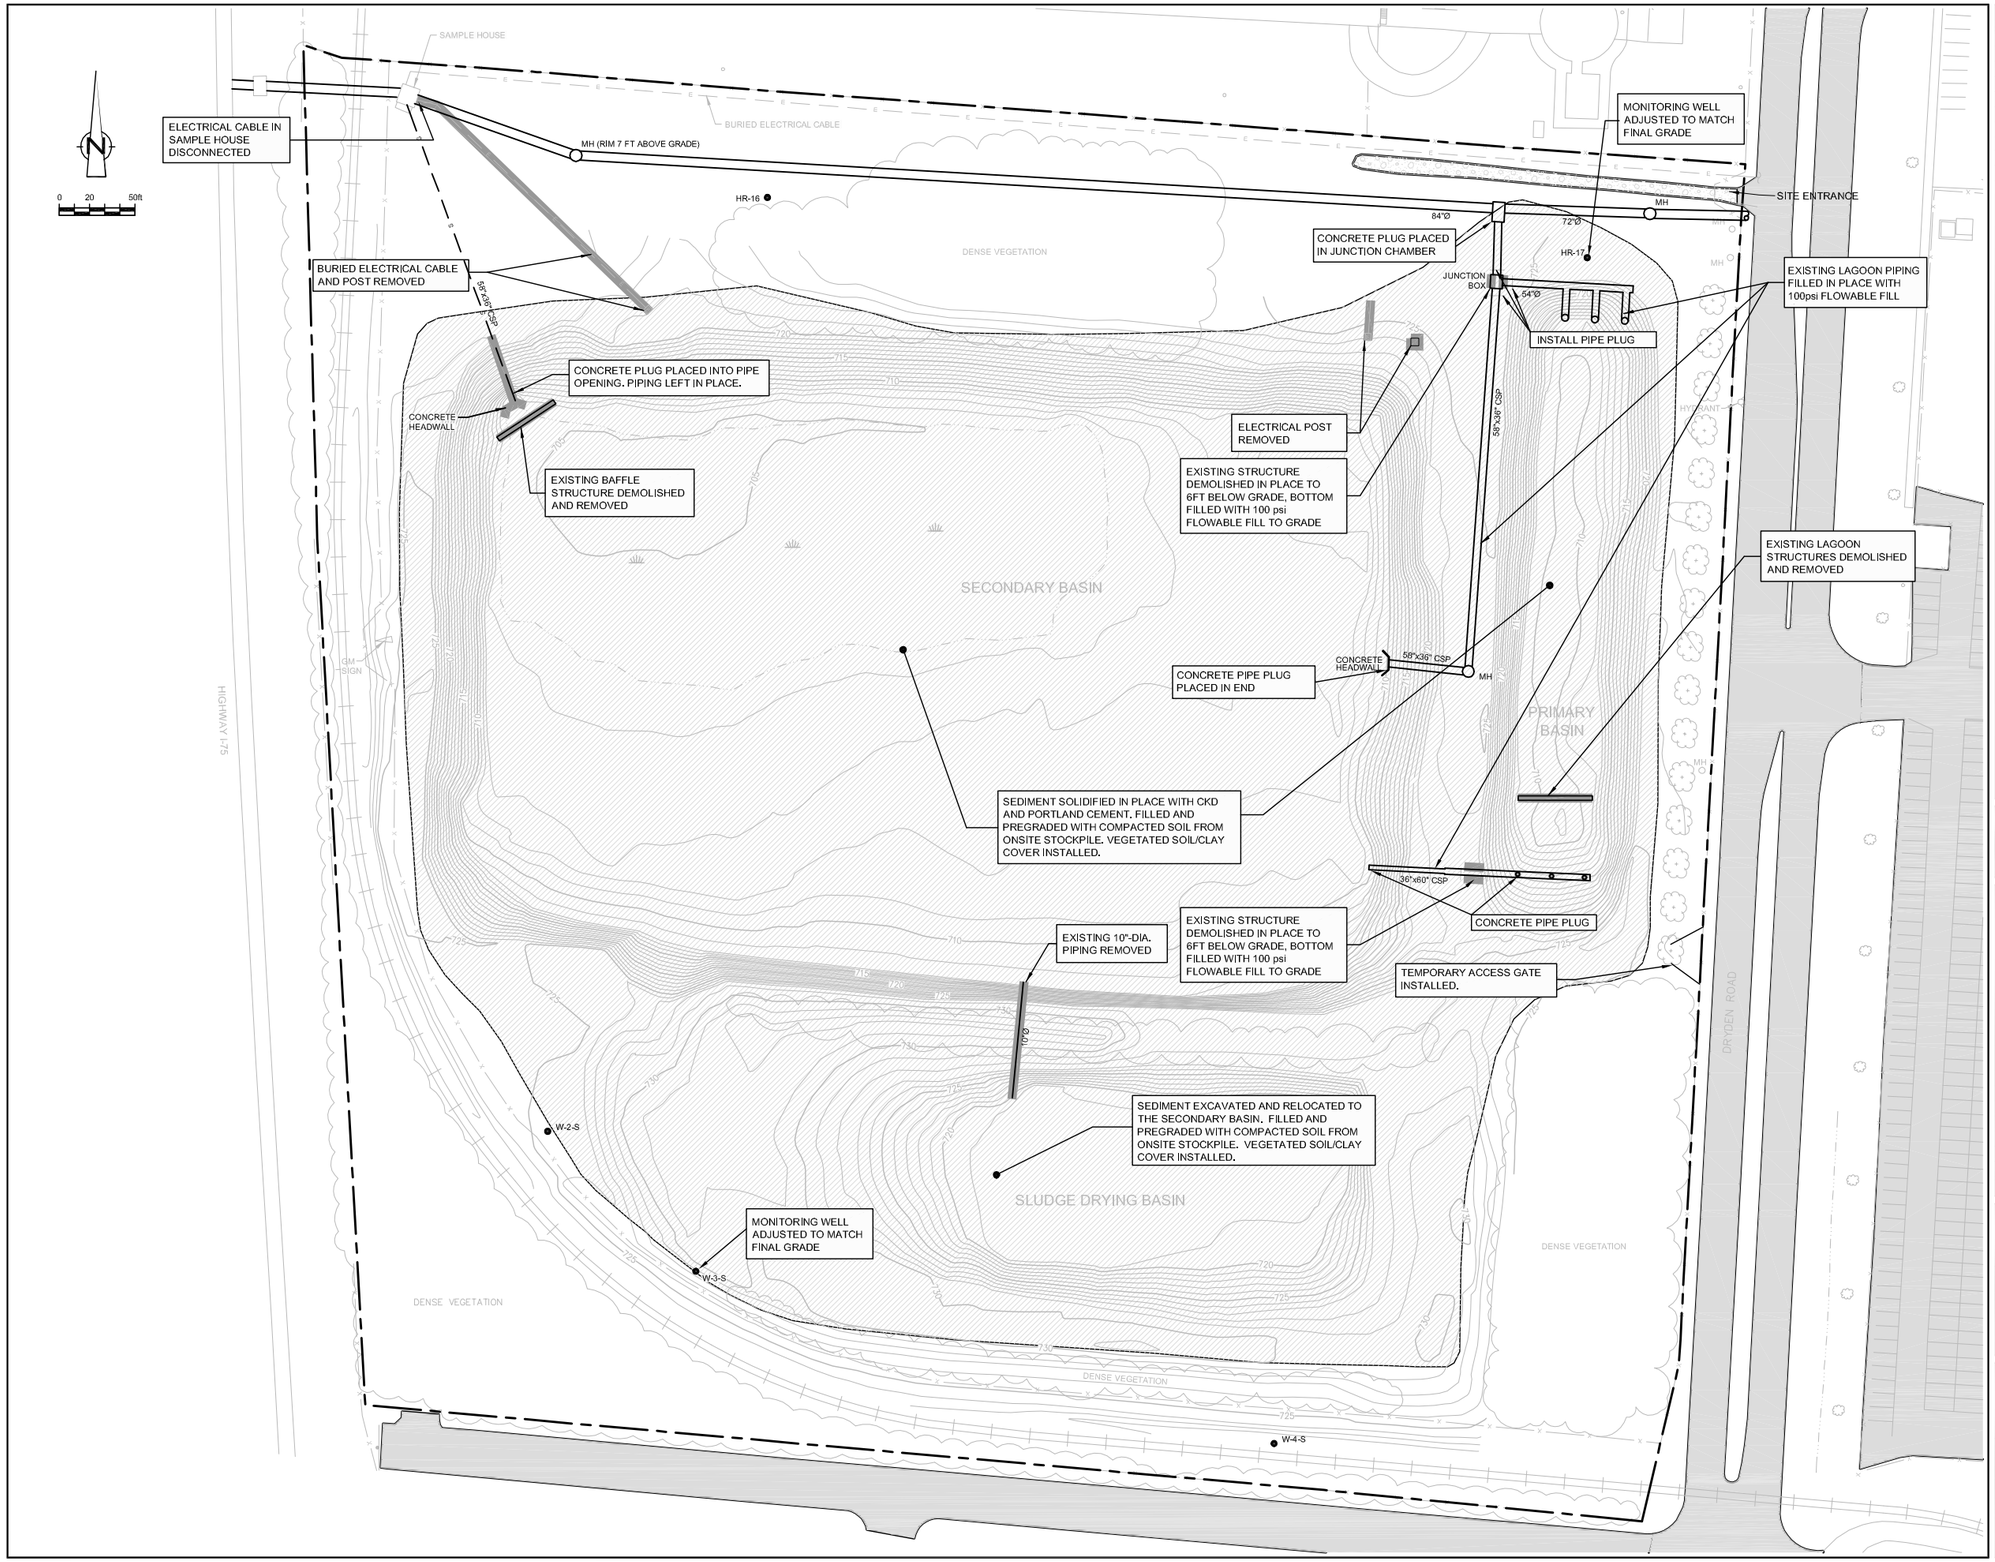

Nº	Revision	Date	Initial

LEGEND

NEW	EXISTING	
		APPROXIMATE LOT LINE
		FENCE
		ASPHALT PAVEMENT
		GRAVEL SURFACE
		EDGE OF WATER
		RAILROAD
		VEGETATION
		WET AREA
	725	CONTOUR AND ELEVATION (ft.)
	S	STORMWATER SEWER
	CSP	CORRUGATED STEEL PIPE
		UNDERGROUND PIPING
	E	ELECTRICAL CABLE
		TREE
	W-2-S	MONITORING WELL
	HR-17	MONITORING WELL
MH	MH	MANHOLE
		LIMIT OF VEGETATIVE SOIL/CLAY COVER
	S	EXTENT OF PIPING AND LAGOON STRUCTURES DEMOLISHED AND REMOVED

SCALE VERIFICATION

THIS BAR MEASURES 1" ON ORIGINAL. ADJUST SCALE ACCORDINGLY.

Approved

DRAWING STATUS

Status	Date	Initial

HARRISON RADIATOR DIVISION FACILITY
MORAINE, OHIO

AS BUILT

SITE WORK
SOUTH LAGOON

CONESTOGA-ROVERS & ASSOCIATES

Source Reference:
JUDGE ENGINEERING, SURVEY RECEIVED OCTOBER 11, 2000

Project Manager:	Reviewed By:	Date:	
I. RICHARDSON	J. WINTERINK	AUGUST 2001	
Scale: 1"=50'	Project Nº: 12611-02	Report Nº: 005	Drawing Nº: PLAN 4

12611-02(005)GN-WA004 AUG 10/2001